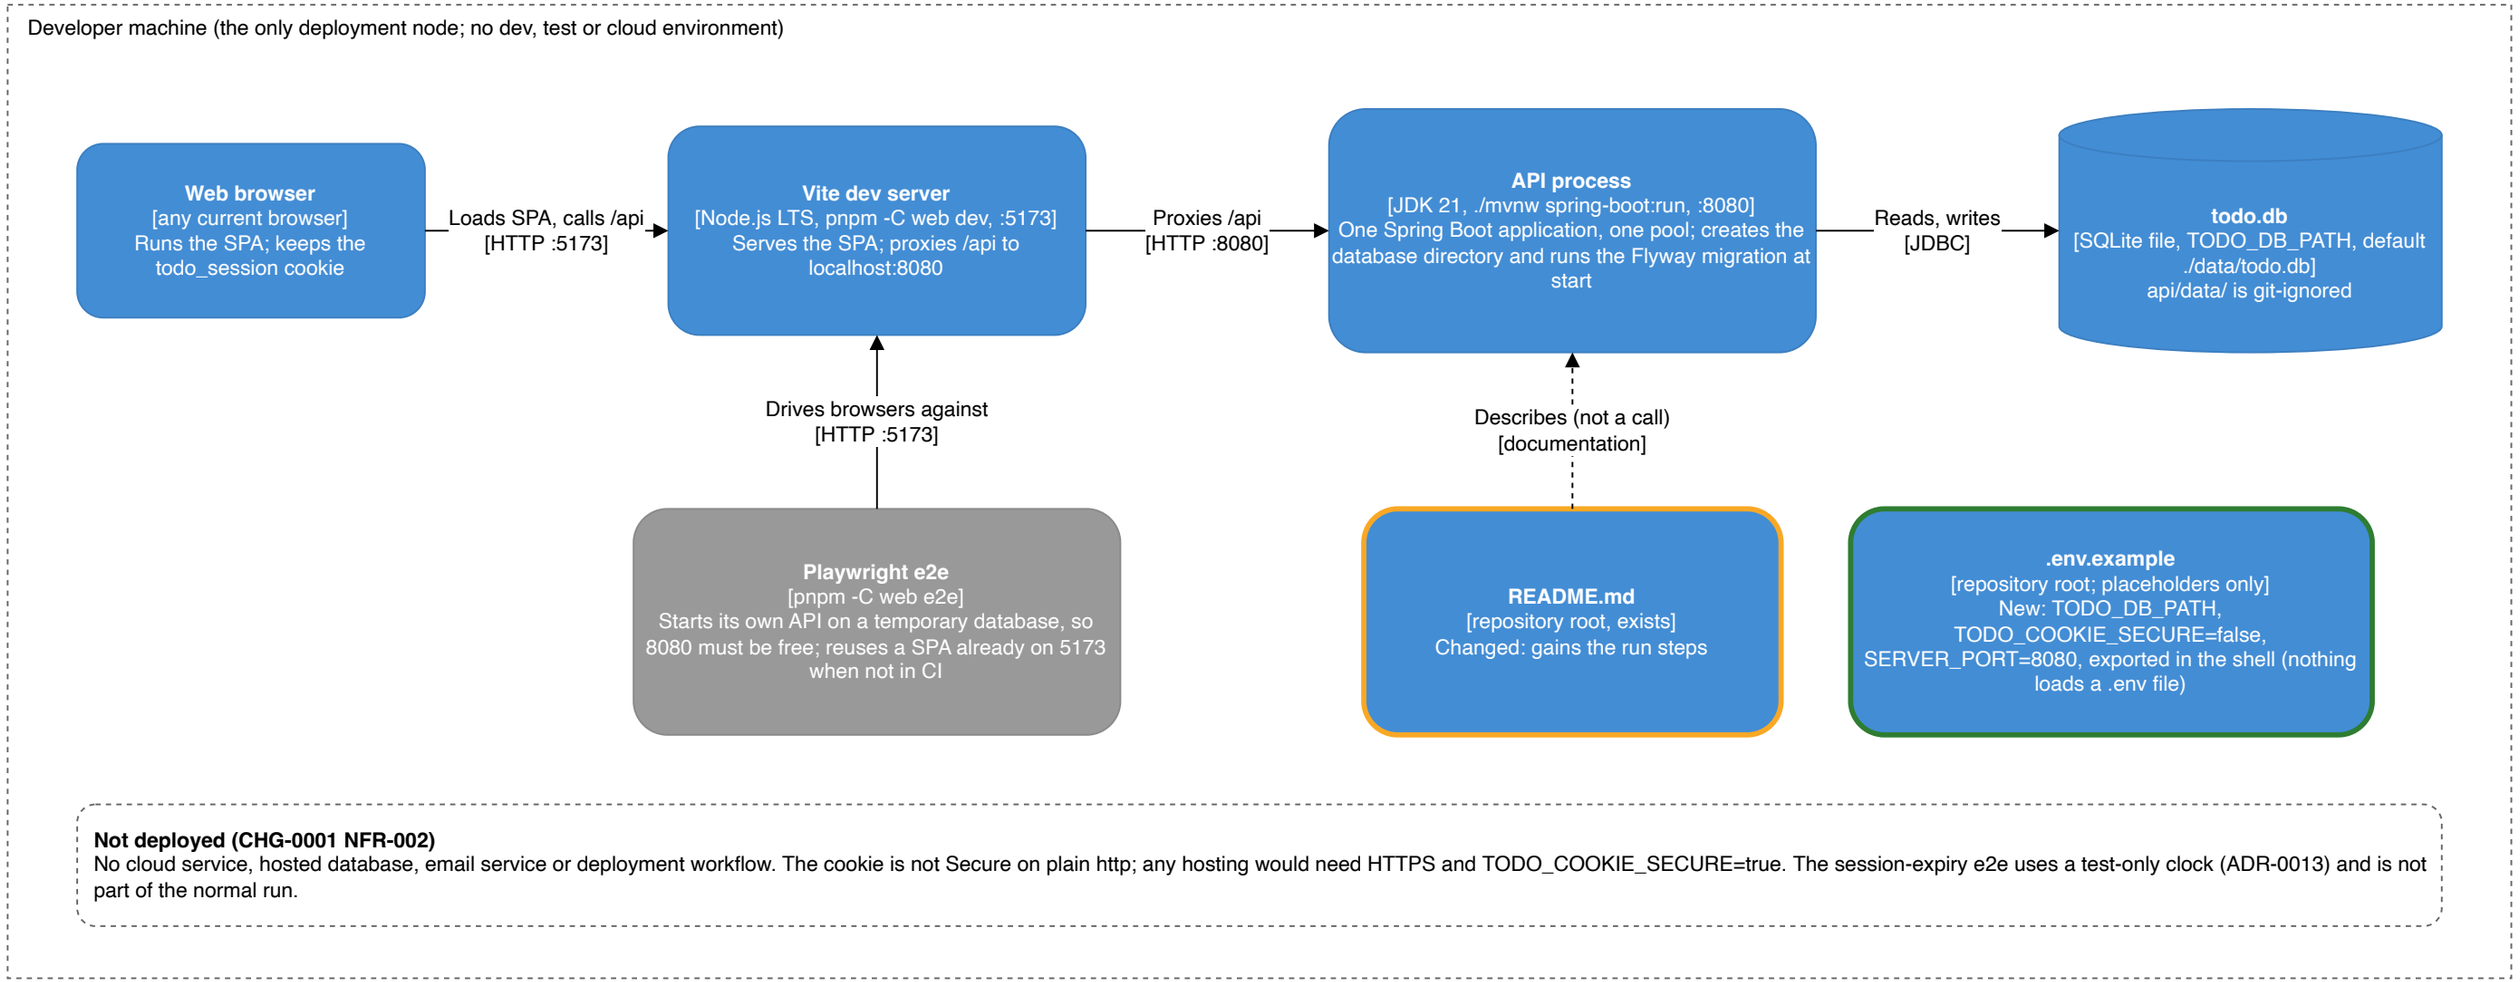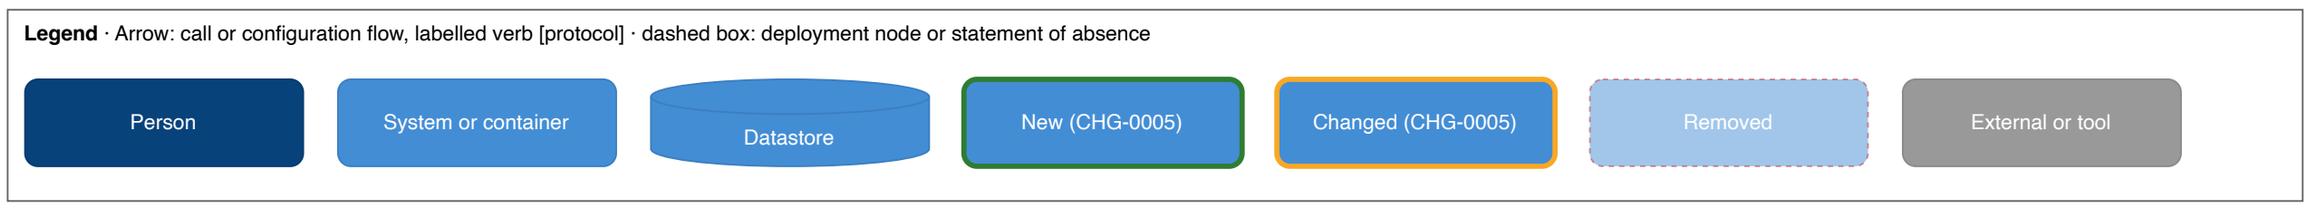To-do app · Deployment view: native run (as built by CHG-0001)
CHG-0005 · 2026-11-13
Green: new in CHG-0005 (.env.example). Yellow: changed (README.md run steps). Nothing else in this view changes.